


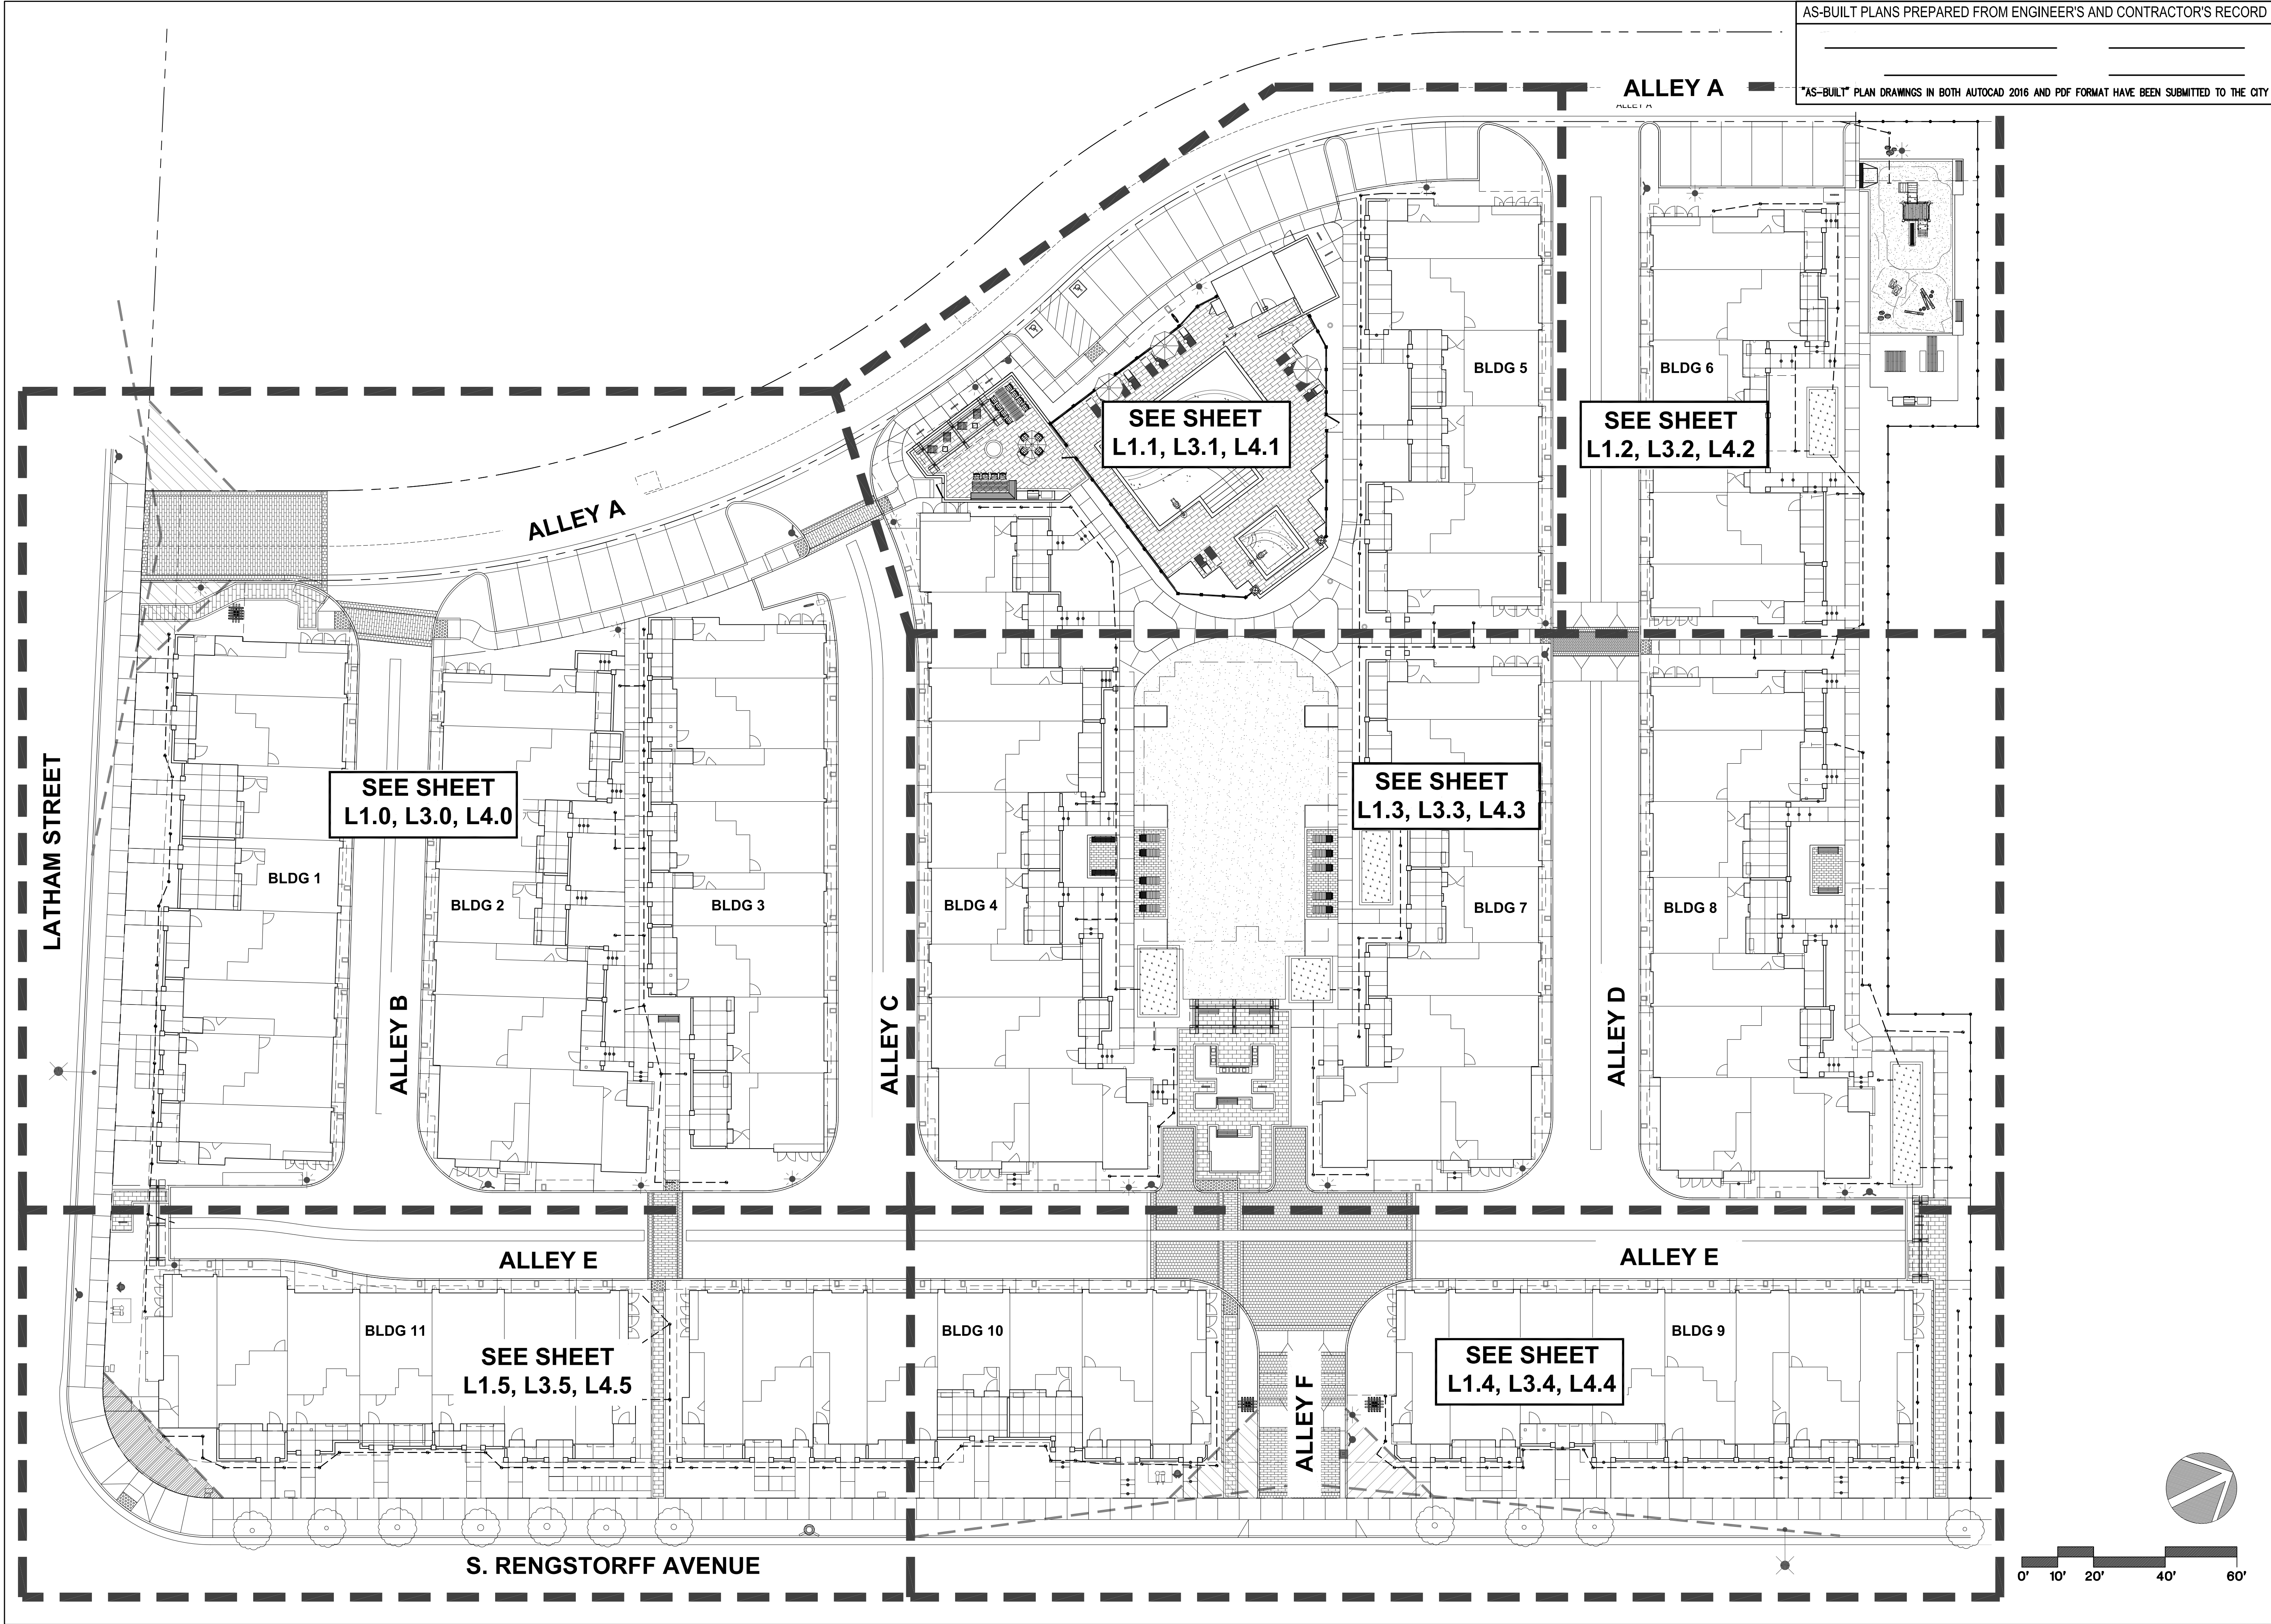

AS-BUILT PLANS PREPARED FROM ENGINEER'S AND CONTRACTOR'S RECORD

"AS-BUILT" PLAN DRAWINGS IN BOTH AUTOCAD 2016 AND PDF FORMAT HAVE BEEN SUBMITTED TO THE CITY

CLIENT:

TAYLOR MORRISON
4309
SUITE 450
PLEASANTON
CALIFORNIA 94588
925.659.0119

811
SAFE DIGGING PARTNER

LICENSED LANDSCAPE ARCHITECT
JULIA R. ABED
LIC. NO. 45874
STATE OF CALIFORNIA

VAN DORN ABED
LANDSCAPE ARCHITECTS, INC.
81 14TH ST. SAN FRANCISCO, CA
94103 PH (415) 864-9221 FAX (415) 864-4796

PROJECT MANAGER: MW
DESIGNED BY: HN
CHECKED BY: JVA

PROJECT NAME / LOCATION:
570 S. RENGSTORFF AVENUE
MOUNTAIN VIEW
DRAWING TITLE:
LANDSCAPE CONSTRUCTION DRAWINGS

REVISIONS:	NO.	DESCRIPTION	BY:	DATE

KEY MAP

SCALE:
1"=20'-0"

ISSUE DATE:
08/01/2023

PROJECT NO.:
V2202

SHEET NO.:
L0.1
53 OF 110